


BLOCK 1 Ce 250 kg/m³

RAMBOLL PURISTIN HEIJARI N _c 10 KESKIMÄÄRÄ 10	KOHDE TNO 1716 PISTE 2517 KONE 74 KOSE-MÄO M16/1 PK2/100		
	PVM. 31.03.09	TUTK.	
	SUUNN.	TARK.	
		MITTAKAAVA 1:100	
	PISTEET 2516 2517 2518 2519 2539		

mp. ka = +71.90 (+71.70 - +72.01)

GROUND LEVEL
(AVERAGE)

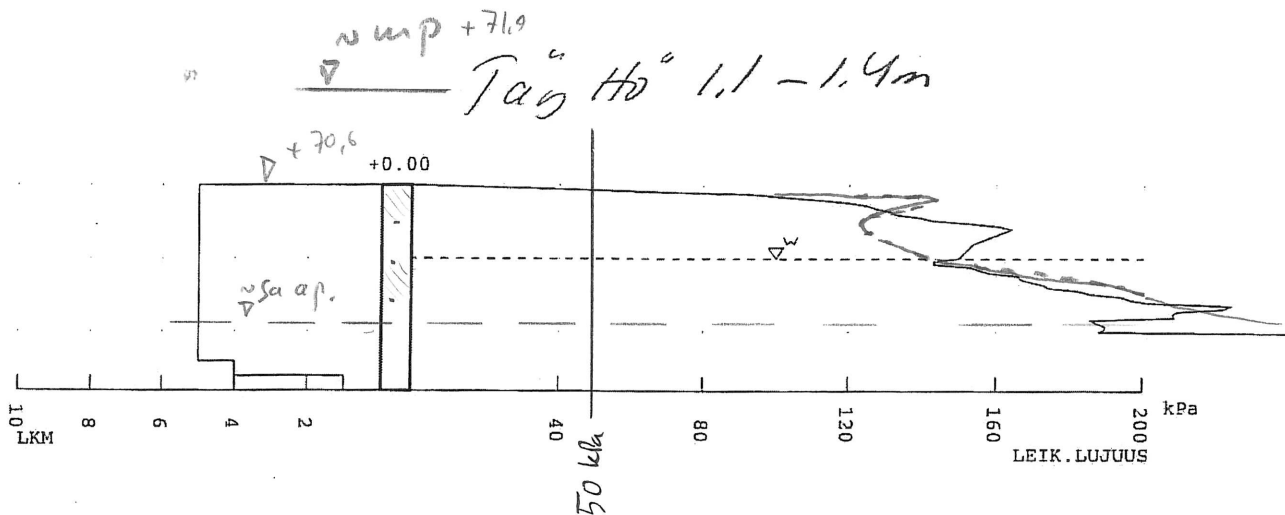

BLOCK 2

Ce + Sand 250+100 kg/m³

RAMBOLL

KOHD

TNO

1716

PISTE

2514

KONE

74

KOSE-MÄO M23/2

PK2/100

PVM. 31.03.09

TUTK.

~~PURISTIN HEIJARI~~N_c 10

SUUNN.

TARK.


KESKJARVO 2a

MITTAKAAVA 1:100

PISTEET

2512 2513 2514

$$m p k_{a.} = +72.09 \quad (+71.97 - +72.22)$$

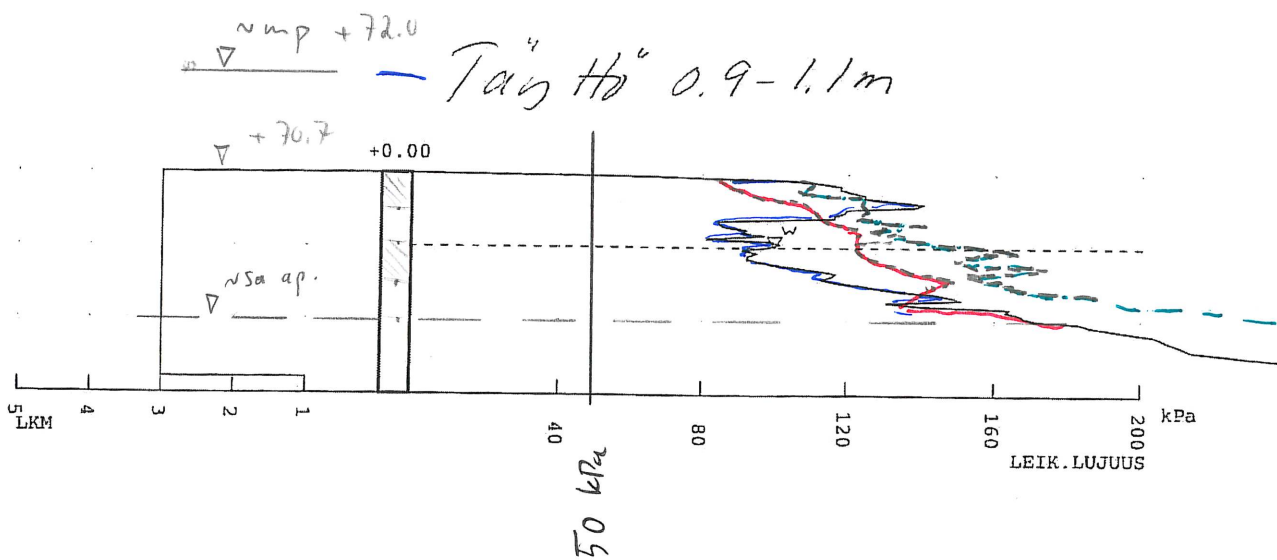

$\sim$ TÄYTÖ 1,3...1,4 m


$\sim$ TÄYTÖ 1,8 m

BLOCK 3

Ce + Ash 100 + 100 kg/m³

RAMBOLL PURISTIN HEIJARI N _c 10 KESKIJARVO 3a	KOHDE	TNO 1716	PISTE 2511	KONE 74
	KOSE-MÄO M32/3 PK2/100			
	PVM. 30.03.09	TUTK.		
	SUUNN.	TARK.		
		MITTAKAAVA 1:100		
		PISTEET 2508 2509 2511 2564		

$$m_p \text{ ka.} = +72.14 \text{ } (+72.04 - +72.25)$$

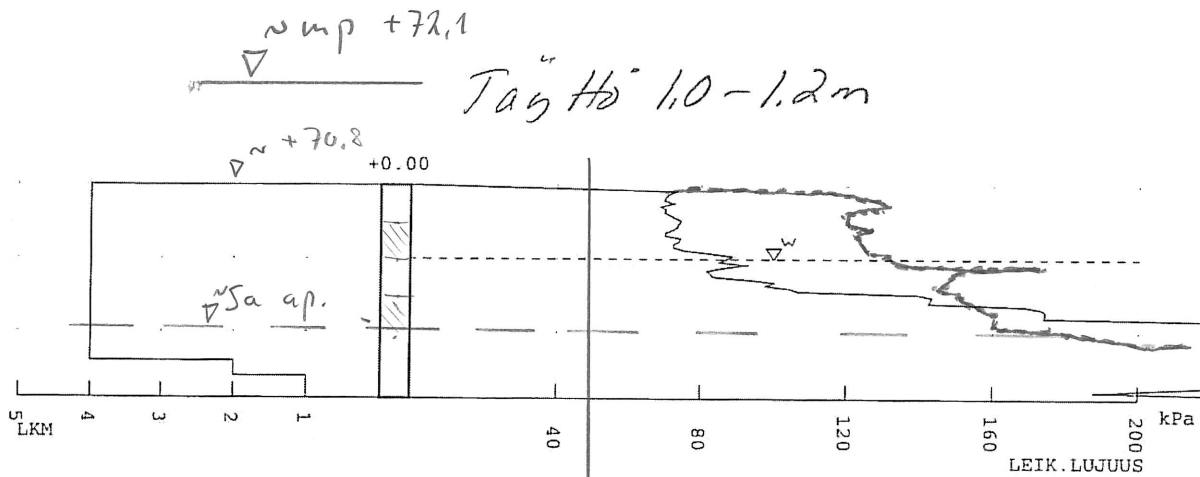


50 m

TÄYTTÖ 1.3... 1.5 m

BLOCK 4/1

Ce + Ash 100 + 200 kg/m³

RAMBOLL PURISTIN HEIJARI N _c 10 KESKIARVO 4a	KOHDE TNO 1716 PISTE 2524 KONE 74 KOSE-MÄO M44/4 PK2/100		
	PVM. 31.03.09	TUTK.	
	SUUNN.	TARK.	
		MITTAKAAVA 1:100	
		PISTEET 2524 2525	

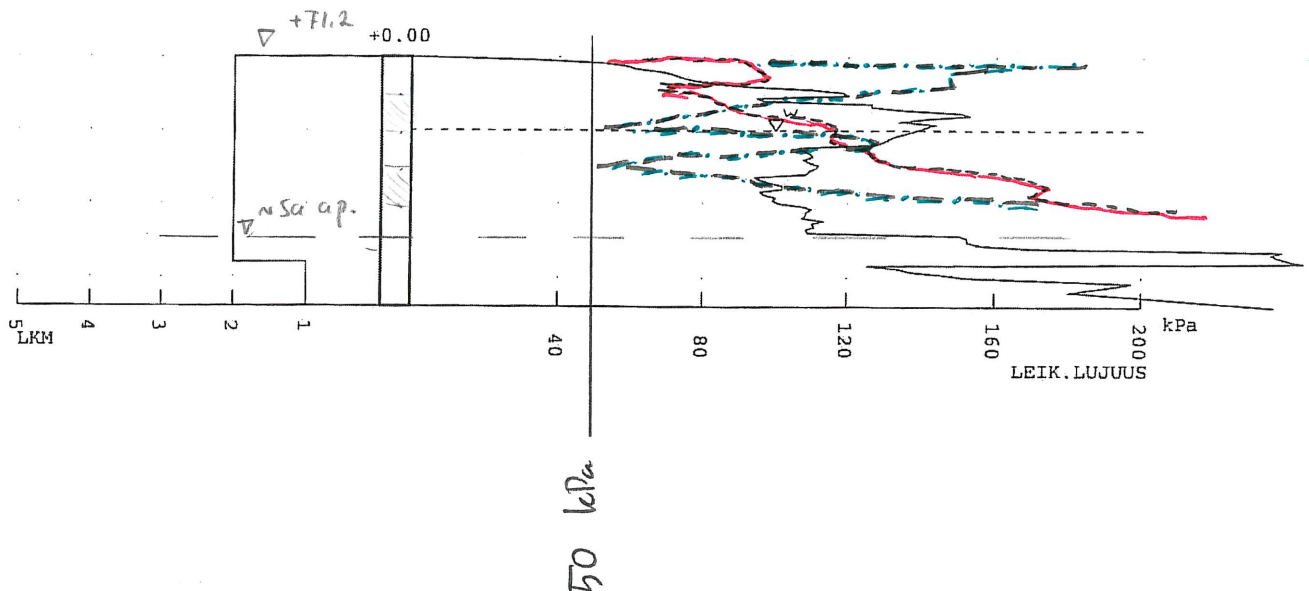
 $m_p \text{ ka.} = +72.43 \quad (+72.04 - +72.25)$
 $\nabla \sim m_p +72.4$
Täy H⁰ 0,6 - 0,8 m

~~—~~ TÄYTTÖ 1,0 ... 1,1 m

- - - TÄYTTÖ 1,2 ... 1,3 m

BLOCK 4/2 Ce+Ash 100+200 kg/m³

RAMBOLL PURISTIN - HEIJARI N _c 10 KESKIJARVO 46	KOHDE TNO 1716 PISTE 2550 KONE 74 KOSE-MÄO M47/4 PK2/100	
	PVM. 02.04.09	TUTK.
	SUUNN.	TARK.
	MITTAKAAVA 1:100 PISTEET 2550 2551 2552	
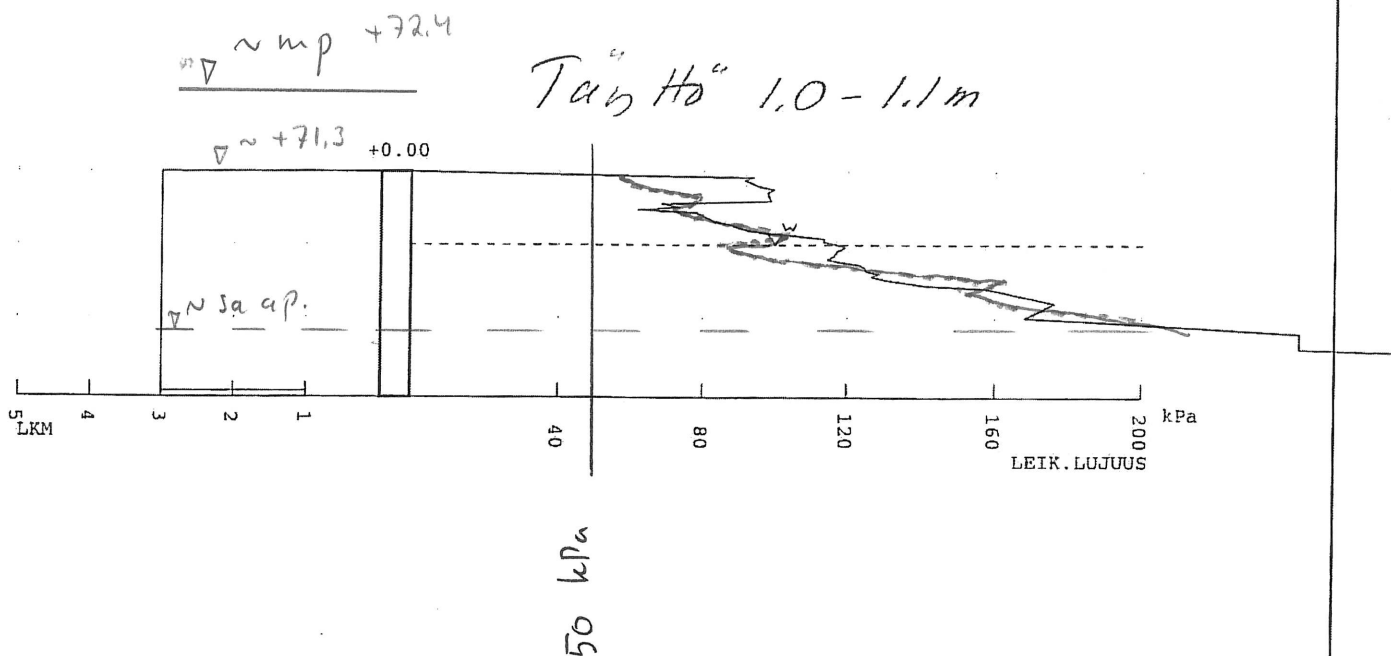
$$m_p k_a = +72,43 (+72,26 - +72,54)$$




Täy Hö 2,1 m

BLOCK 5.2 Sideaine Ce+Ash 150+200 $\frac{kg}{m^2}$

RAMBOLL PURISTIN — HEIJARI N _c 10 KESKJARVO 5a	KOHDE TNO 1716 PISTE 2535 KONE 74 KOSE-MÄO M54/5 PK2/100	
	PVM. 01.04.09	TUTK.
	SUUNN.	TARK.
	MITTAKAAVA 1:100	
	PISTEET 2533 2534 2535	

$$mp. ka. = +72.35 \quad (+72.23 - +72.56)$$

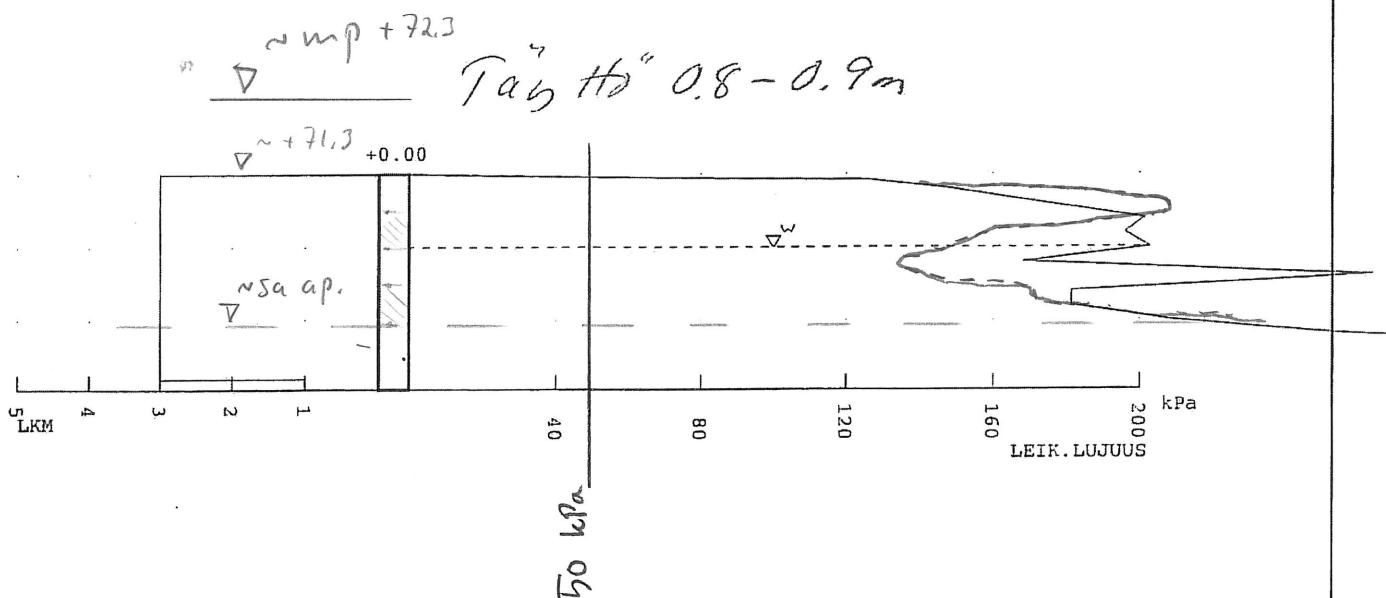


— Täy Hö" 1,2...1,3 m

BLOCK 6

(c + Ash 70+100 kg/m³)

RAMBOLL PURISTIN HEIJARI N _c 10 KESKIARVO 60	KOHDE TNO 1716 PISTE 2545 KONE 74 KOSE-MÄO M66/6 PK2/100	
	PVM. 01.04.09	TUTK.
	SUUNN.	TARK.
	MITTAKAAVA 1:100 PISTEET 2506 2544 2545 2546 2547	

$$m_p \text{ ka.} = +72,34 \text{ } (+72,15 - +72,42)$$

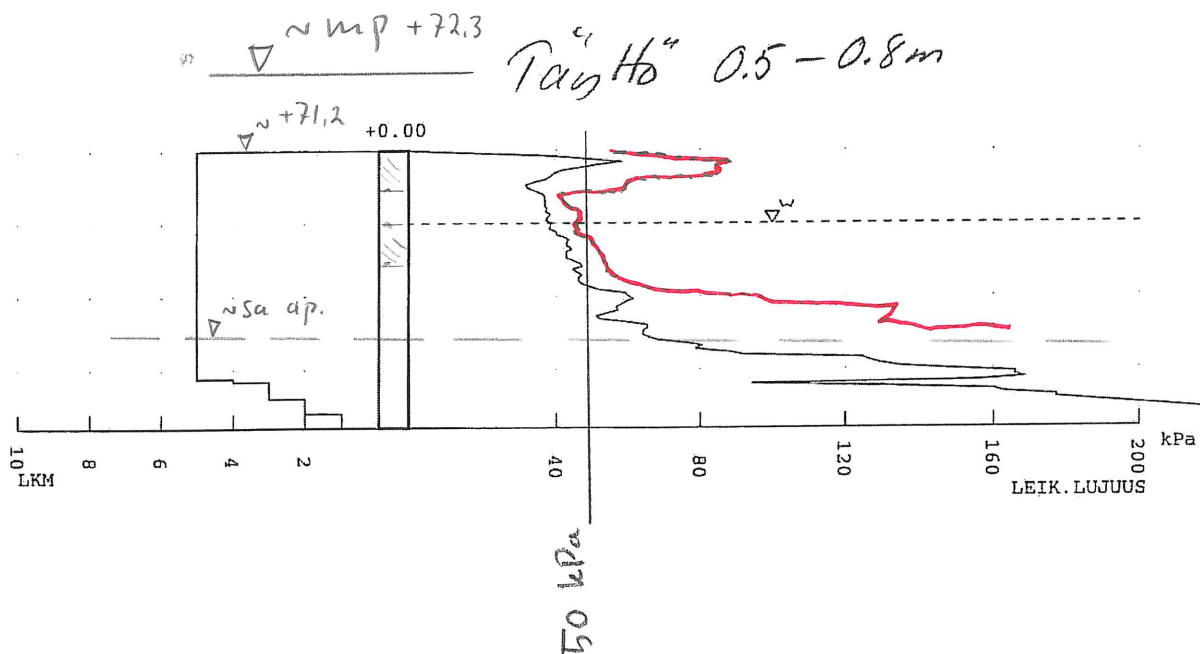

— Täy Hö 1,2 ... 1,3 m

Huom! Kentan eteläosa "sortui" stabiloituksessa

OBS! SOUTHERN EDGE OF THE BLOCK COLLAPSED.


DURING STABILISATION

BLOCK 7

Ce 200 kg/m³

RAMBOLL PURISTIN - HEIJARI N _c 10 KESKIARVO 70	KOHDE TNO 1716 PISTE 2528 KONE 74 KOSE-MÄO M77/7 PK2/100	
	PVM. 31.03.09	TUTK.
	SUUNN.	TARK.
	MITTAKAAVA 1:100 PISTEET 2528 2529 2530 2556 2557 2558	

$$m_p \text{ ka.} = +72,37 (+72,25 - +72,50)$$

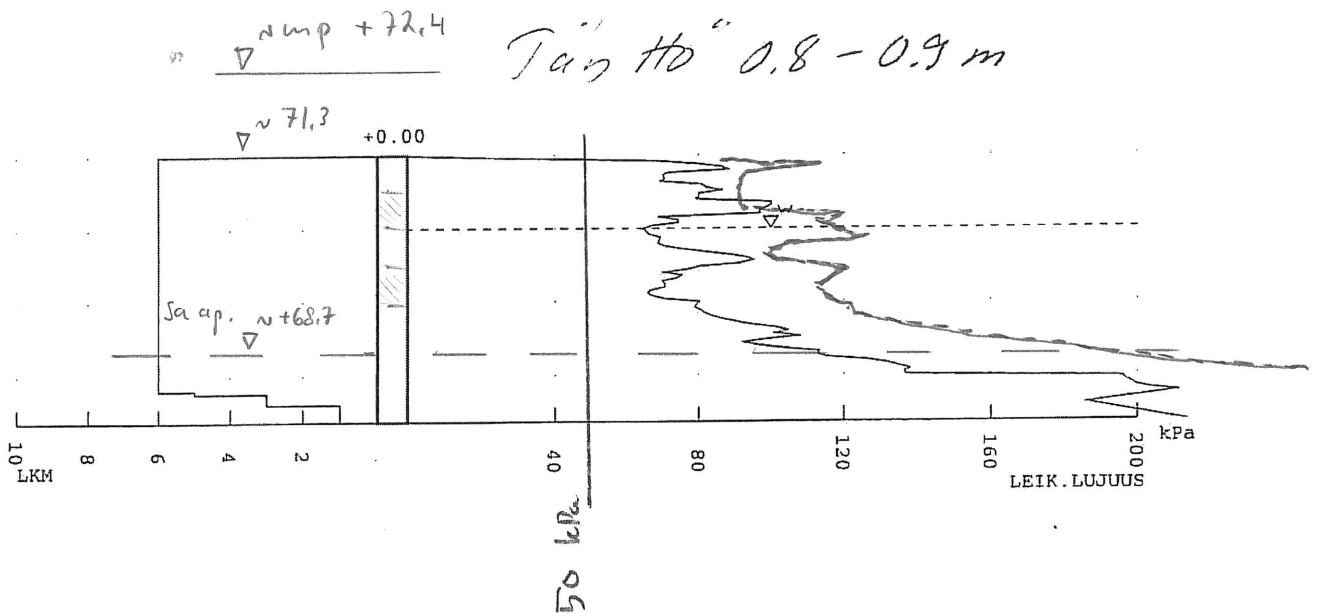


— Tāy Hö' 1.1... 1.2 m

BLOCK 8

Ce 150 kg/m³

RAMBOLL PURISTIN HEIJARI N _c 10 KESKIARVO 89	KOHDE TNO 1716 PISTE 2526 KONE 74 KOSE-MÄO M84/8 PK2/100	
	PVM. 31.03.09	TUTK.
	SUUNN.	TARK.
	MITTAKAAVA 1:100	
	PISTEET 2503 2520 2526 2527	

$$m_p \text{ ka.} = +72.70 \quad (+72.15 - +72.44)$$

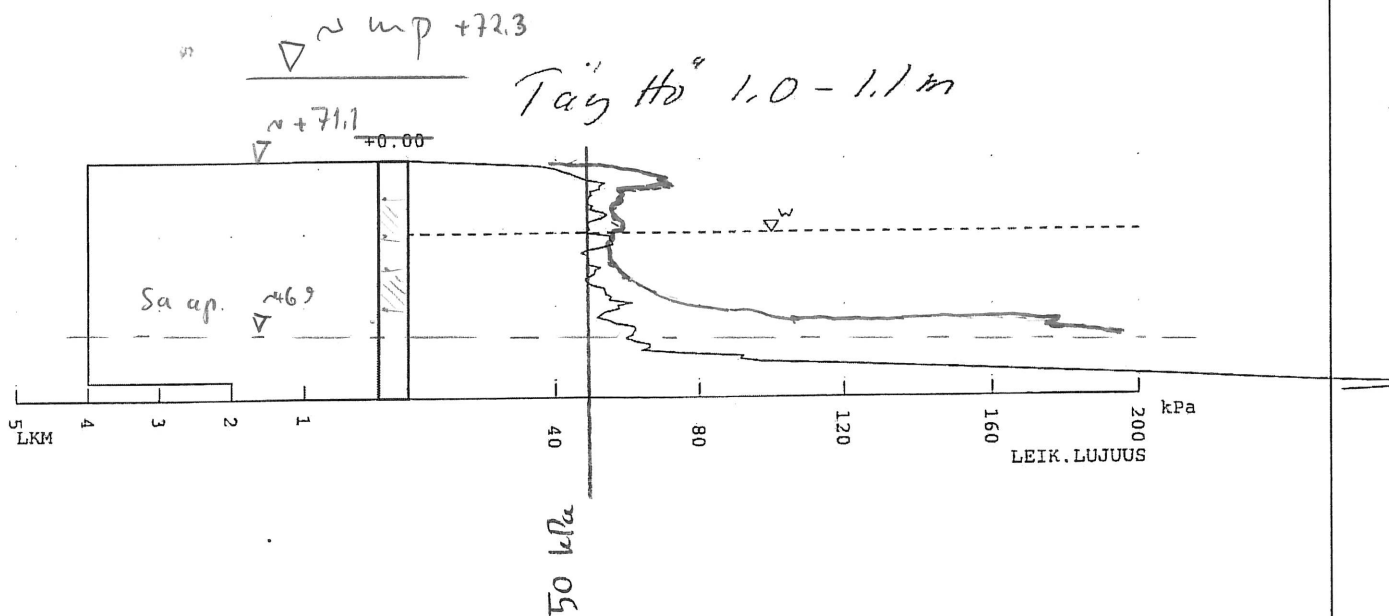

— Täy Hö 1,2 ... 1,3 m